

FIG. 2A



Inventor: Shiu-Yuan Chen
 Application No.: 09/882,766
 Reply to Office Action Dated 04/07/04
 Attorney Docket: 16869B-024900US
 Replacement Sheet for Fig. 2B

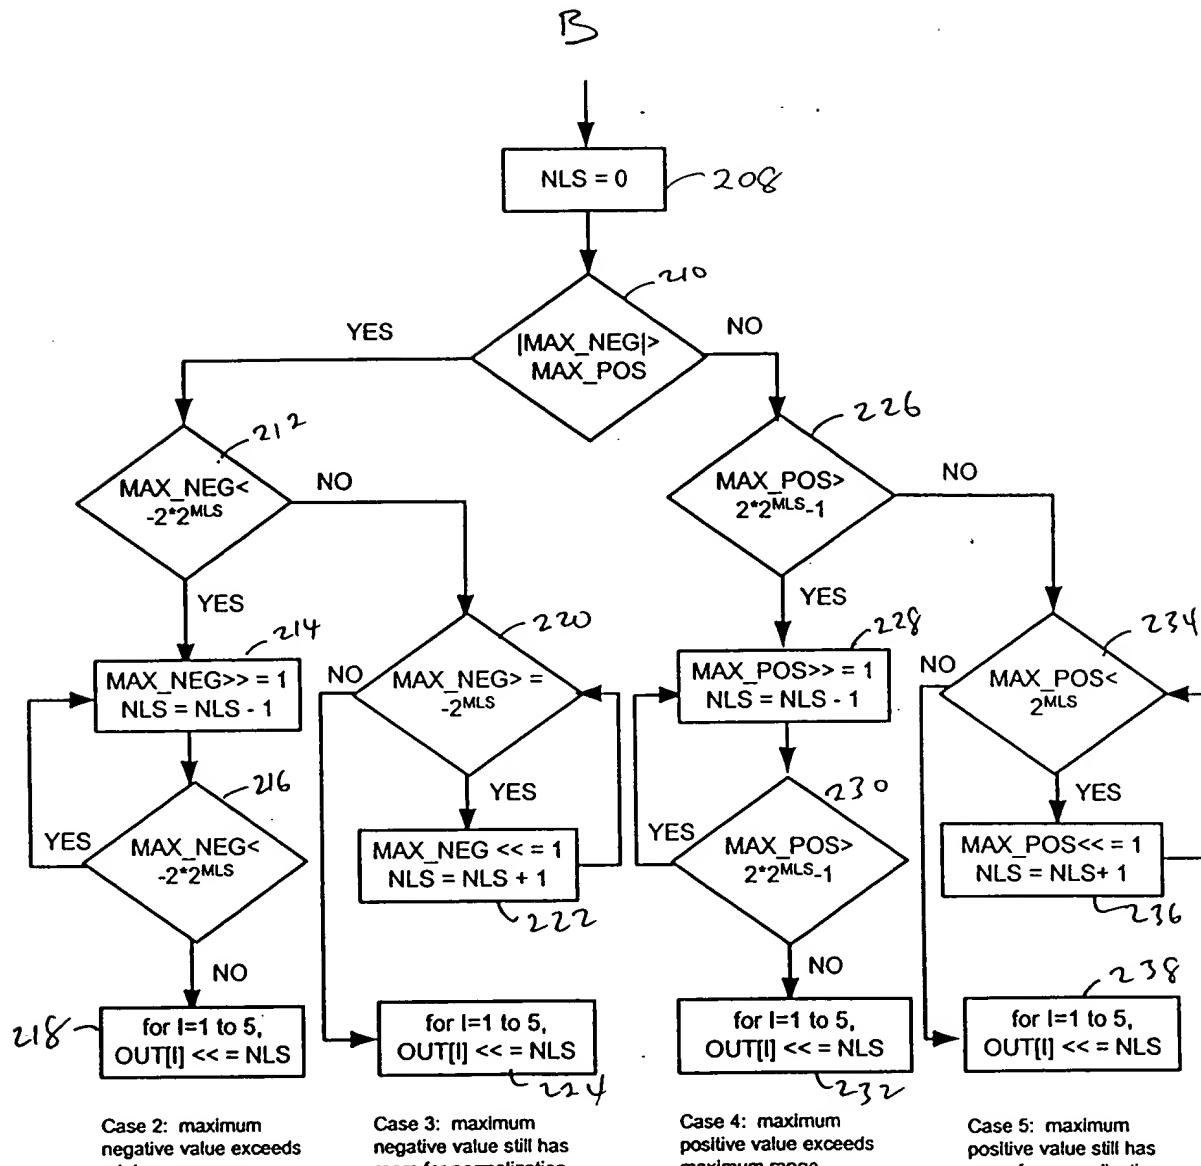


FIG. 2B


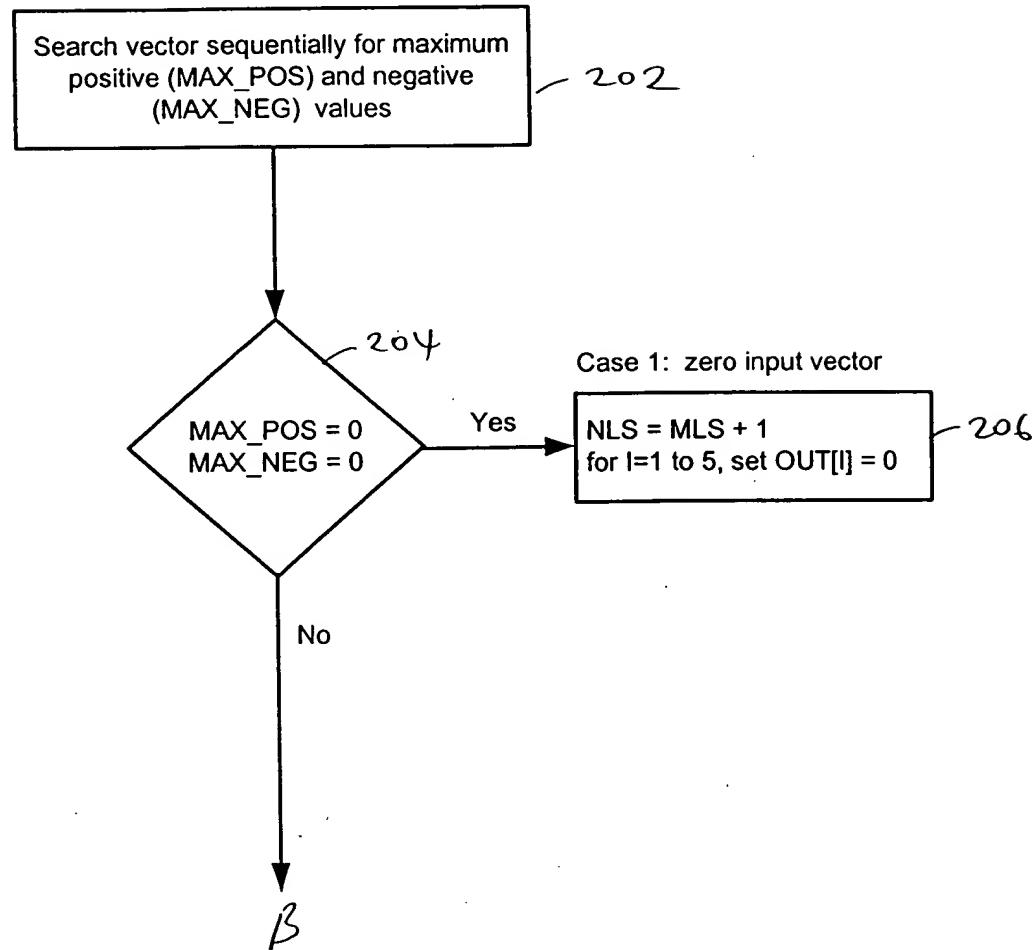


FIG. 2A



Inventor: Shiuh-Yuan Chen
Application No.: 09/882,766
Reply to Office Action Dated 04/07/04
Attorney Docket: 16869B-024900US
Red line Copy Showing Changes Fig 2B

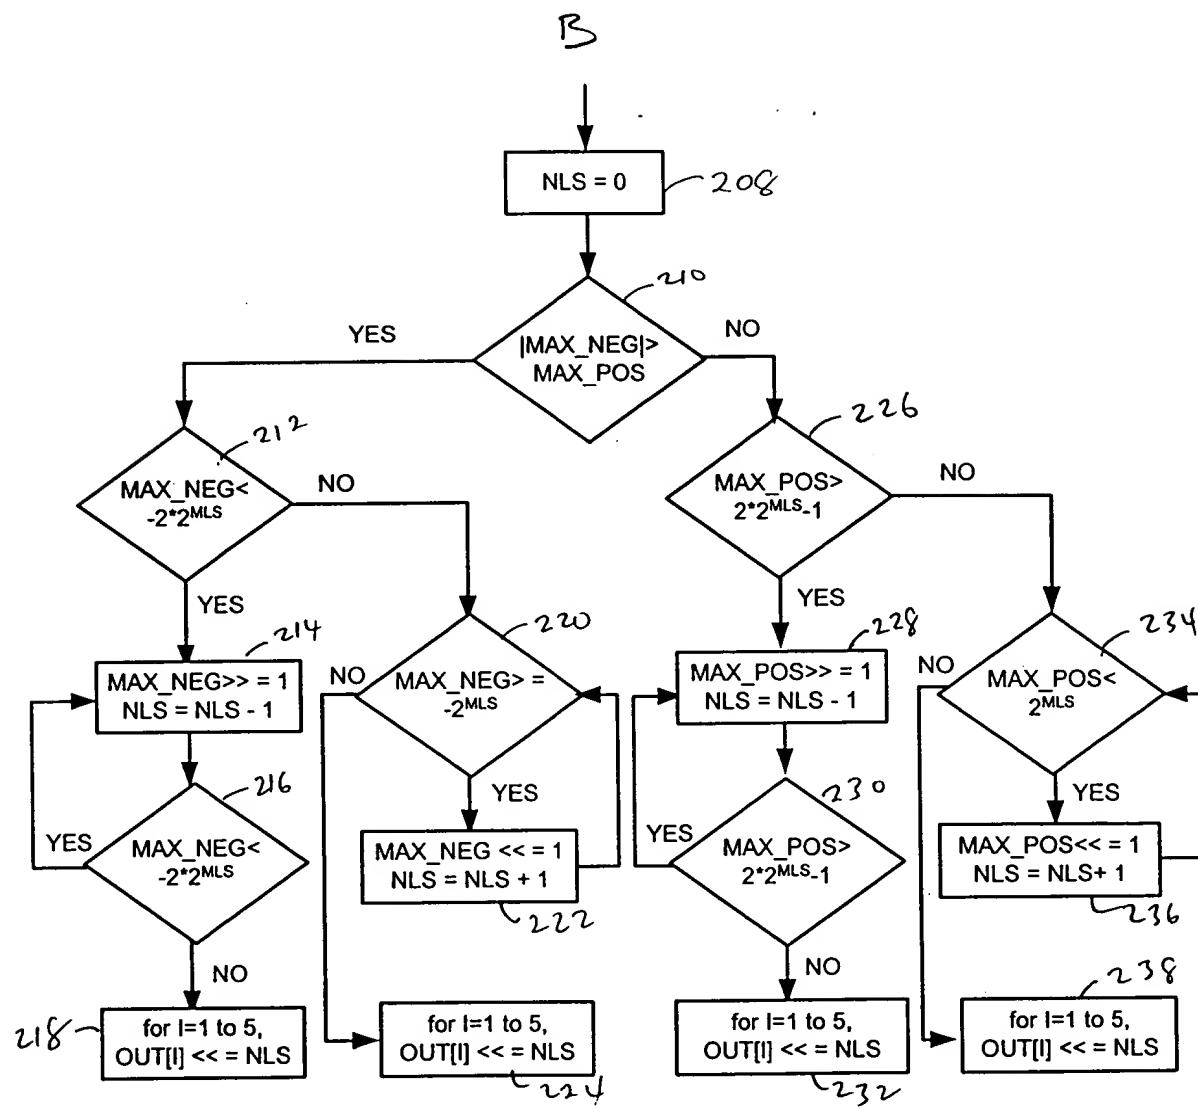

Case 2: maximum negative value exceeds minimum range

Case 3: maximum negative value still has room for normalization

Case 4: maximum positive value exceeds maximum range

Case 5: maximum positive value still has room for normalization

FIG. 2B